


# ASIA

## LEGEND

As built: October 2017  
Maps are not to scale.

Learn more about our network:  
[teliacarrier.com](http://teliacarrier.com)

- Point of presence (PoP)
- Multiple PoPs
- Telia Carrier fiber
- Leased network
- Sea cable

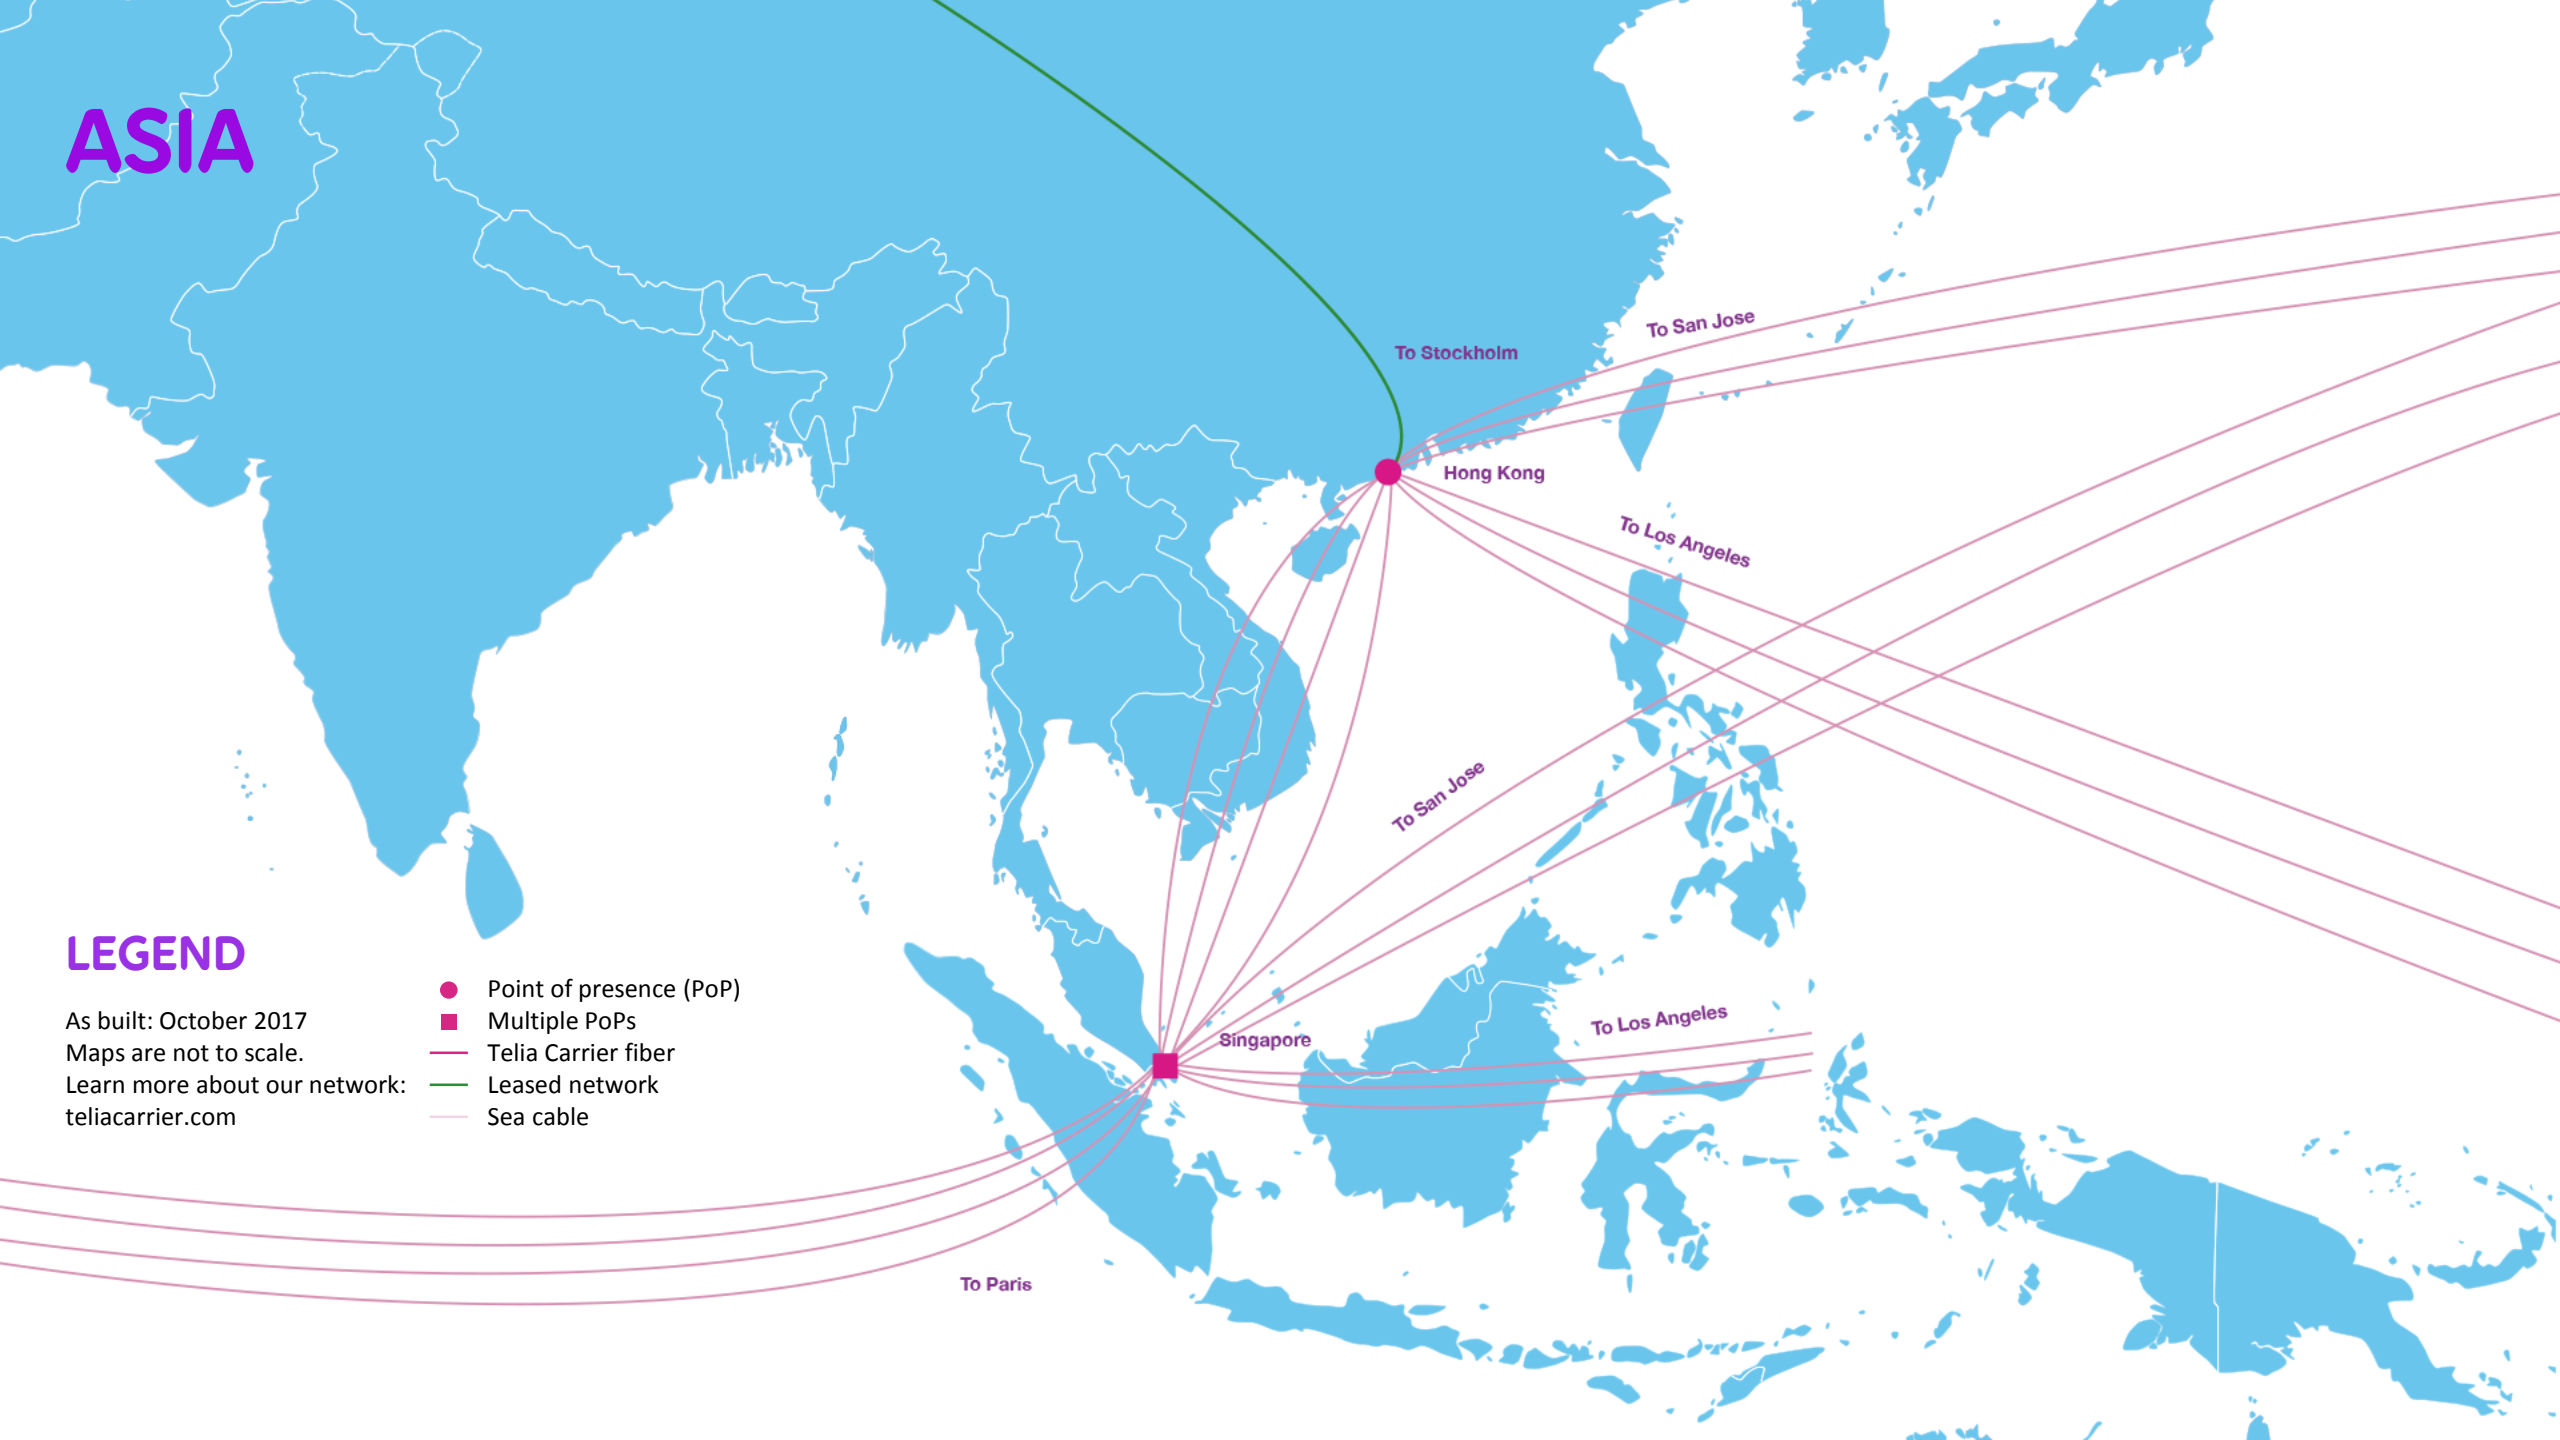

# OUR PoPs IN ASIA

## **Hong Kong**

399 Chai Wan Road

## **Singapore**

Block 20, Ayer Rajah Crescent,

Equinix

2 Tai Seng Avenue, Global Switch

